


STATE ENGINEER  
Salem, Oregon

Well Record <sup>28 NE</sup> STATE WELL NO. 17/3W-14E  
GR- 1305 <sup>1138</sup> COUNTY Lane  
APPLICATION NO. GR- 1349

OWNER: Olaf Egge MAILING ADDRESS: Rt. 2, Box 328

LOCATION OF WELL: Owner's No. CITY AND STATE: Eugene, Oregon

SW 1/4 NW 1/4 Sec. 14 T. 17 N. S. R. 3 W., W.M.  
Bearing and distance from section or subdivision  
corner 650' E. & 2360' S. from NW cor. Sec. 14

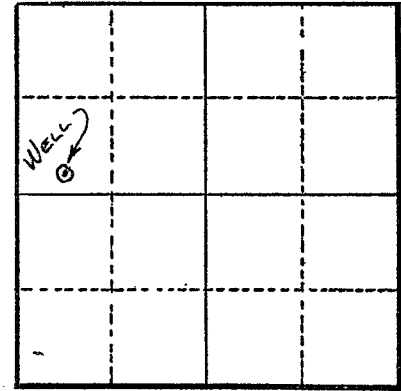

Altitude at well

TYPE OF WELL: Driven Date Constructed 1951

Depth drilled 21 ft. Depth cased 21 ft.

Section 14

CASING RECORD:  
4 inch

FINISH:  
Perforated: from 16 to 21 ft.

AQUIFERS:  
Sand & gravel

WATER LEVEL:  
8 ft.

PUMPING EQUIPMENT: Type Berkeley 2 in. Cent. H.P. 5  
Capacity 80 G.P.M.

WELL TESTS:  
Drawdown ft. after hours G.P.M.  
Drawdown ft. after hours G.P.M.

USE OF WATER Irrigation Temp. °F. 19

SOURCE OF INFORMATION G. R. Record

DRILLER or DIGGER

ADDITIONAL DATA:  
Log N.A. Water Level Measurements Chemical Analysis Aquifer Test

REMARKS:  
Irrigation of 5 acres.