

STATE ENGINEER
Salem, Oregon

Well Record ~~LANE~~ STATE WELL NO. 17/3W-15P
COUNTY Lane
APPLICATION NO. GR-4008

OWNER: Harold E. Rice


MAILING ADDRESS: Route 2, Box 272

LOCATION OF WELL: Owner's No.

CITY AND STATE: Eugene, Oregon

SE 1/4 SW 1/4 Sec. 15 T. 17 N. S., R. 3 E. W., W.M.

Bearing and distance from section or subdivision
corner 37.99 chs. E. of NW Cor. of Lander
donation land claim #45 thence S. 16.8 chs.,
E. .5 ch.

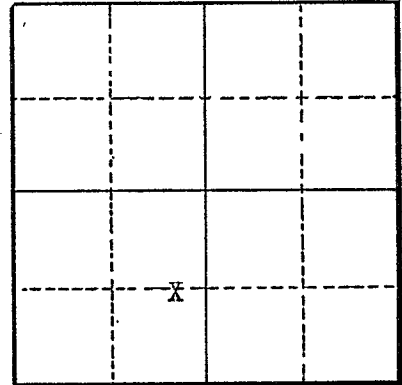

Section 15

Altitude at well

TYPE OF WELL: Dug Date Constructed Aug., 1948

Depth drilled 12 feet Depth cased 12 feet

CASING RECORD:

36 inch casing set to 12 feet

FINISH:

AQUIFERS:

WATER LEVEL:

6 feet below surface

PUMPING EQUIPMENT: Type Fairbanks Morse H.P. 7 1/2

Capacity 175 G.P.M.

WELL TESTS:

Drawdown 3 ft. after hours 175+ G.P.M.

Drawdown 1 ft. after hours 100 G.P.M.

USE OF WATER Irrigation Temp. °F., 19

SOURCE OF INFORMATION Well Registration Statement Cert. # GR-3615

DRILLER or DIGGER

ADDITIONAL DATA:

Log Water Level Measurements Chemical Analysis Aquifer Test

REMARKS: