

STATE ENGINEER
Salem, Oregon

Well Record

LANE
1140


STATE WELL NO. 17/3W-15J
COUNTY LANE
APPLICATION NO. GR-2584

OWNER: Larry Clemenson or Helen S. Clemenson
MAILING ADDRESS: Rt. 2, Box 238

LOCATION OF WELL: Owner's No. _____
CITY AND STATE: Eugene, Oregon

NE 1/4 SE 1/4 Sec. 15 T. 17 N. S., R. 3 E. W., W.M.

Bearing and distance from section or subdivision
corner 1630' S. of Deadmond Ferry Road

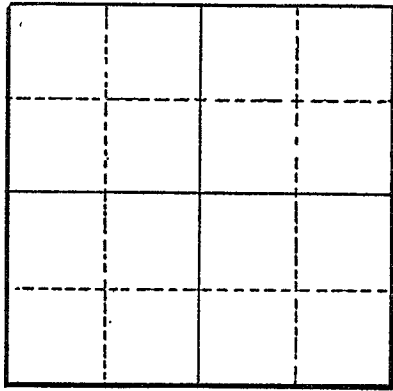

Section _____

Altitude at well _____

TYPE OF WELL: Trench Date Constructed 1935

Depth drilled 14 Depth cased _____

CASING RECORD:

FINISH:

AQUIFERS:

WATER LEVEL:

Varies

PUMPING EQUIPMENT: Type Allis Chalmers Rotary H.P. 20
Capacity _____ G.P.M.

WELL TESTS:

Drawdown _____ ft. after _____ hours _____ G.P.M.
Drawdown _____ ft. after _____ hours _____ G.P.M.

USE OF WATER Irrigation Temp. _____ °F. _____, 19

SOURCE OF INFORMATION GR-2452

DRILLER or DIGGER _____

ADDITIONAL DATA:

Log _____ Water Level Measurements _____ Chemical Analysis _____ Aquifer Test _____

REMARKS: