

STATE ENGINEER
Salem, Oregon

Well Record **LANE** STATE WELL NO. 17/3W-16H
COUNTY Lane
APPLICATION NO. GR-3913

1171

OWNER: Ellen Marie Pruitt MAILING ADDRESS: Route 2, Box 278
CITY AND STATE: Eugene, Oregon


LOCATION OF WELL: Owner's No. SE 1/4 NE 1/4 Sec. 16 T. 17 S., R. 3 W., W.M.

Bearing and distance from section or subdivision corner

Altitude at well

TYPE OF WELL: open-dug Date Constructed 6/10/38

Depth drilled 11 ft. Depth cased

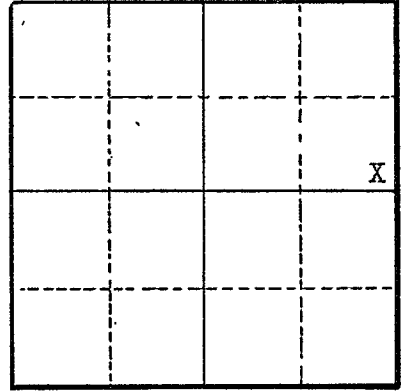

Section 16

CASING RECORD:

FINISH:

AQUIFERS:

WATER LEVEL:

10 feet below surface

PUMPING EQUIPMENT: Type Fairbanks Morse H.P. 10
Capacity 150 G.P.M.

WELL TESTS:

Drawdown ft. after hours G.P.M.
Drawdown ft. after hours G.P.M.

USE OF WATER Irrigation Temp. °F., 19

SOURCE OF INFORMATION Well Registration Statement Cert. # GR-3551

DRILLER or DIGGER

ADDITIONAL DATA:

Log Water Level Measurements Chemical Analysis Aquifer Test

REMARKS: