

STATE ENGINEER
Salem, Oregon

Well Record LANE STATE WELL NO. 17/3W-17A# 1
COUNTY Lane
APPLICATION NO. GR-83

OWNER: Austin E. & Lucy John


MAILING ADDRESS: 3060 Co. Farm Road

LOCATION OF WELL: Owner's No. _____

CITY AND STATE: Eugene, Oregon

NE ¼ NE ¼ Sec. 17 T. 17 S., R. 3 W., W.M.

Bearing and distance from section or subdivision
corner 350 ft. S. & 450 ft. W. of NE cor. Sec. 17

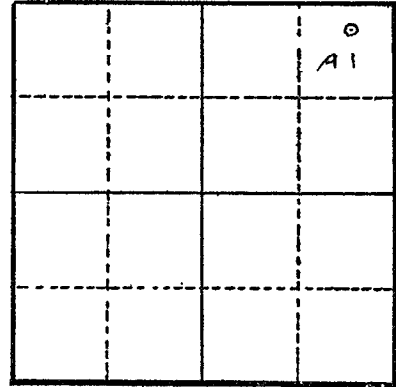

Section 17

Altitude at well 400 ft.

TYPE OF WELL: drilled Date Constructed 9/28/54

Depth drilled 39 Depth cased 39

CASING RECORD: 6 inch

FINISH:

AQUIFERS:

WATER LEVEL: 10 ft.

PUMPING EQUIPMENT: Type centrifugal H.P. 1½
Capacity 60 G.P.M.

WELL TESTS:

Drawdown _____ ft. after _____ hours _____ G.P.M.

Drawdown _____ ft. after _____ hours _____ G.P.M.

USE OF WATER domestic, irrigation Temp. _____ °F. _____, 19

SOURCE OF INFORMATION Reg. St. GR-83

DRILLER or DIGGER _____

ADDITIONAL DATA:

Log _____ Water Level Measurements _____ Chemical Analysis _____ Aquifer Test _____

REMARKS: