

STATE ENGINEER
Salem, Oregon


Well Record

LANE STATE WELL NO. 17/3W-18B
1121 COUNTY Lane
APPLICATION NO. GR-3718

OWNER: Nancy B. Ray
MAILING ADDRESS: Route 2, Box 73
CITY AND STATE: Eugene, Oregon

LOCATION OF WELL: Owner's No. NE 1/4 NE 1/4 Sec. 18 T. 17 S., R. 3 W., W.M.

Bearing and distance from section or subdivision corner 597' N. and 129' E. of NW cor. of Dan'l S. Snelling D.L.C. #41

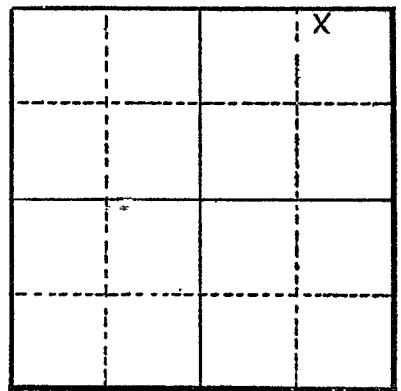

Section 18

Altitude at well

TYPE OF WELL: Driven Date Constructed Jan., 1932

Depth drilled 20 feet Depth cased

CASING RECORD:

6-2" pipes driven 18 feet into the ground

FINISH:

Well perforated three feet from bottom with 3/8 inch holes 2 inches apart.

AQUIFERS:

WATER LEVEL:

12 feet below surface

PUMPING EQUIPMENT: Type Fairbanks Morse H.P. 5
Capacity 200 G.P.M.

WELL TESTS:

Drawdown ft. after hours 320 G.P.M.
Drawdown ft. after hours G.P.M.

USE OF WATER Irrigation Temp. °F., 19

SOURCE OF INFORMATION Well Registration Statement

DRILLER or DIGGER

ADDITIONAL DATA:

Log Water Level Measurements Chemical Analysis Aquifer Test

REMARKS:

3395