


OWNER: James Seed Company MAILING ADDRESS: 1235 Goodpasture Rd.

LOCATION OF WELL: Owner's No. CITY AND STATE: Eugene, Oregon

SW 1/4 NW 1/4 Sec. 18 T. 17 S., R. 3 W., W.M.

Bearing and distance from section or subdivision corner N. 42°30' E. 2362 ft. from SW Cor. of DLG 70

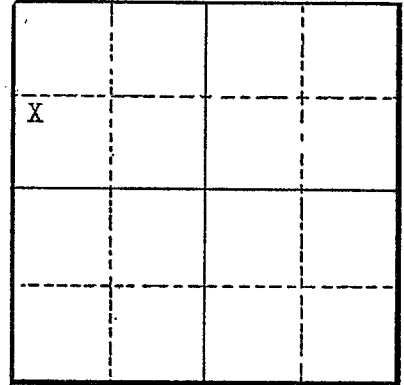

Section 18

Altitude at well

TYPE OF WELL: Dug Date Constructed 1926

Depth drilled 19 ft. Depth cased 19 ft.

CASING RECORD:

36 inch diameter, 3" concrete well casing set from 2 to 19 feet

FINISH:

No perforations - open bottom

AQUIFERS:

WATER LEVEL:

16 feet below surface

PUMPING EQUIPMENT: Type Deming centrifugal Fairbanks Morse centrifugal *Berkeley turbine Capacity 100, 500, *200 G.P.M. H.P. 5, 25, *7 1/2

WELL TESTS:

Drawdown 0.5 ft. after 800 hours G.P.M.
Drawdown ft. after hours G.P.M.

USE OF WATER Irrigation & Industrial Temp. °F., 19

SOURCE OF INFORMATION Well Registration Statement Cert. # GR-3629

DRILLER or DIGGER

ADDITIONAL DATA:

Log Water Level Measurements Chemical Analysis Aquifer Test

REMARKS:

Log: River loam Thickness 10 Depth to Bottom 10
Sand and gravel, water bearing 9 19