

STATE ENGINEER
Salem, Oregon

Well Record

LANE
11/21/6


STATE WELL NO. 17/3W-18H
COUNTY Lane
APPLICATION NO. GR-3719

OWNER: Philip A. McKenzie and
M. Evelyn McKenzie
LOCATION OF WELL: Owner's No. _____

MAILING ADDRESS: 1155 Norkenzie Rd.
CITY AND STATE: Eugene, Oregon

SE 1/4 NE 1/4 Sec. 18 T. 17 N. S., R. 3 E. W., W.M.

Bearing and distance from section or subdivision
corner 1262' S. & 359' W. of SW cor. of the
Alvin B. Stevens DIC # 40

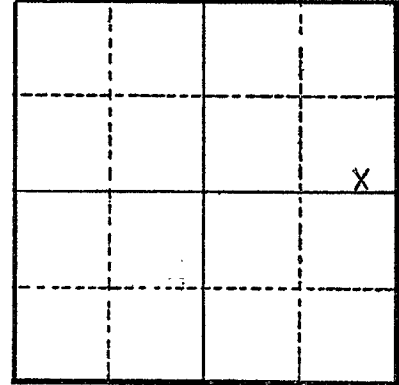

Section 18

Altitude at well _____

TYPE OF WELL: Driven Date Constructed May, 1954
Depth drilled 20 ft Depth cased 20 ft.

CASING RECORD:

2 inch casing set to 20 feet

FINISH:

perforated with 3/8 in. holes 2 in. apart for three feet from the bottom

AQUIFERS:

WATER LEVEL:

12 feet below surface

PUMPING EQUIPMENT: Type Fairbanks Morse H.P. 10
Capacity 200 G.P.M.

WELL TESTS:

Drawdown _____ ft. after _____ hours _____ G.P.M.
Drawdown _____ ft. after _____ hours _____ G.P.M.

USE OF WATER Irrigation Temp. _____ °F., 19 _____

SOURCE OF INFORMATION Well Registration Statement

DRILLER or DIGGER _____

ADDITIONAL DATA:

Log _____ Water Level Measurements _____ Chemical Analysis _____ Aquifer Test _____

REMARKS:

3396