

STATE ENGINEER  
Salem, Oregon

# Well Record

STATE WELL NO. 17/3W-18N  
COUNTY Lane  
APPLICATION NO. GR-1311

GR- 1268

11217

OWNER: Elbert L. Cox


MAILING ADDRESS: 1450 Goodpasture Rd.

LOCATION OF WELL: Owner's No.

CITY AND STATE: Eugene, Oregon

SW 1/4 SW 1/4 Sec. 18 T. 17 S, R. 3 W., W.M.

Bearing and distance from section or subdivision corner S5°E, 36.8 ch. from the W<sup>1/4</sup> cor. Sec. 18.

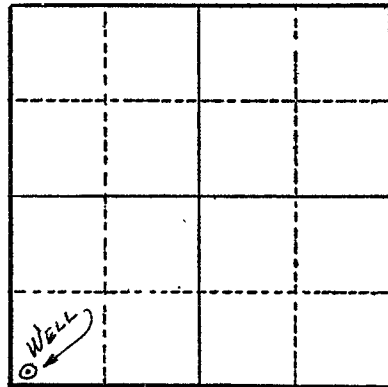

Section 18

Altitude at well

TYPE OF WELL: Drilled Date Constructed 1935

Depth drilled 24 ft. Depth cased 24 ft.

### CASING RECORD:

2 in. from 0 to 24 ft.)  
1 1/2 in. from 0 to 24 ft.) Manifolded

### FINISH:

Perforated from 20 to 24 ft.

### AQUIFERS:

### WATER LEVEL:

20 ft.

PUMPING EQUIPMENT: Type F. M. 2 x 2 1/2 in. H.P. 7 1/2  
Capacity 160 G.P.M.

### WELL TESTS:

Drawdown ft. after hours G.P.M.  
Drawdown ft. after hours G.P.M.

USE OF WATER Irrigation Temp. °F., 19

SOURCE OF INFORMATION G. R. Record

DRILLER or DIGGER Owner

### ADDITIONAL DATA:

Log Water Level Measurements Chemical Analysis Aquifer Test

### REMARKS:

Log: Top soil & clay 0 to 20 ft.  
Gravel 20 to 24 ft.

Irrigation of 10 acres.