

STATE ENGINEER
Salem, Oregon

Well Record

STATE WELL NO. 17/3W-19N
COUNTY Lane
APPLICATION NO. GR-3490

OWNER: Kenneth A. Danstrom


MAILING ADDRESS: 205 Lower Goodpasture Road

LOCATION OF WELL: Owner's No. _____

CITY AND STATE: Eugene, Oregon

SW 1/4 SW 1/4 Sec. 19 T. 17 N. S., R. 3 E. W., W.M.

Bearing and distance from section or subdivision corner N. 2°30' E. 11438' from W.S.W. Corner
from Jacob Gillespie DLC #70

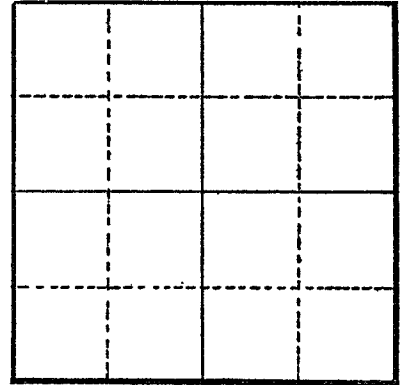

Section _____

Altitude at well _____

TYPE OF WELL: dug Date Constructed 1938

Depth drilled 11' Depth cased -11'

CASING RECORD:

6"
30"

FINISH:

no perforations open bottom

AQUIFERS:

WATER LEVEL:

10'

PUMPING EQUIPMENT: Type Fairbanks Morse H.P. 5
Capacity 150 G.P.M.

WELL TESTS:

Drawdown _____ ft. after _____ hours _____ G.P.M.
Drawdown _____ ft. after _____ hours _____ G.P.M.

USE OF WATER Irrigation Temp. _____ °F., 19 _____

SOURCE OF INFORMATION GR-3221

DRILLER or DIGGER Cecil Buckingham Newport, Oregon

ADDITIONAL DATA:

Log _____ Water Level Measurements _____ Chemical Analysis _____ Aquifer Test _____

REMARKS: