

STATE ENGINEER
Salem, Oregon


Well Record ^{LANE} STATE WELL NO. 17/3W-19N
11232 COUNTY ~~Lane~~
APPLICATION NO. GR-3586

OWNER: Harris D. Hurd MAILING ADDRESS: 305 Lower Goodpasture Rd.

LOCATION OF WELL: Owner's No. CITY AND STATE: Eugene, Oregon

SW 1/4 SW 1/4 Sec. 19 T. 17 S., R. 3 W., W.M.

Bearing and distance from section or subdivision corner 900 ft. N. and 450 ft. E. from SW corner Sec. 19

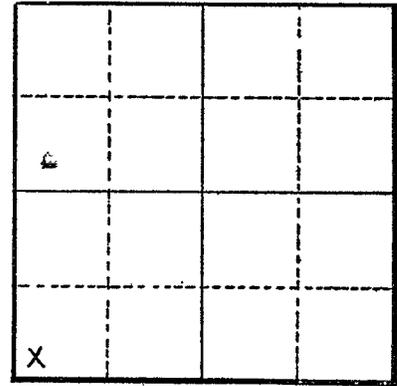

Section 19

Altitude at well

TYPE OF WELL: Driven Date Constructed Aug., 1950

Depth drilled 20 ft. Depth cased

CASING RECORD:

FINISH:

30 inches 1/4" perforations on pipe

AQUIFERS:

WATER LEVEL:

8 feet below surface

PUMPING EQUIPMENT: Type Allis Chalmers H.P. 3
Capacity 60 G.P.M.

WELL TESTS:

Drawdown ft. after hours 130 G.P.M.
Drawdown ft. after hours G.P.M.

USE OF WATER Irrigation Temp. °F., 19

SOURCE OF INFORMATION Well Registration Statement

DRILLER or DIGGER

ADDITIONAL DATA:

Log Water Level Measurements Chemical Analysis Aquifer Test

REMARKS:

Reg. Cert. 3294