

STATE ENGINEER
Salem, Oregon

Well Record

STATE WELL NO. 17/3W-~~19N~~
COUNTY LANE
APPLICATION NO. GR-3078

OWNER: E. D. Harrison

MAILING ADDRESS: 1201 Country Club Rd


LOCATION OF WELL: Owner's No.

CITY AND STATE: Eugene, Oregon

SW ¼ SW ¼ Sec. 19 T. 17 S., R. 3 W., W.M.

Bearing and distance from section or subdivision

corner 800' E 75' N SW cor of Sect 19

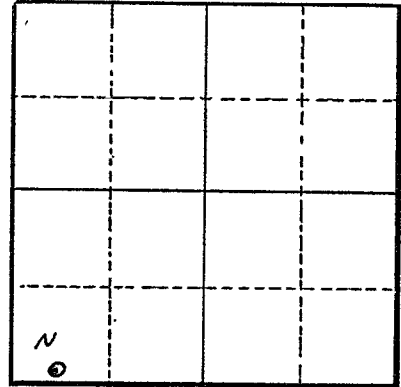

Section 19

Altitude at well

TYPE OF WELL: Dug Date Constructed 1930

Depth drilled 18' 17" Depth cased

CASING RECORD:

FINISH:

AQUIFERS:

WATER LEVEL:

32"

PUMPING EQUIPMENT: Type Fairbanks Morse H.P. 7½
Capacity 250 G.P.M.

WELL TESTS:

Drawdown 12" ft. after _____ hours _____ G.P.M.

Drawdown _____ ft. after _____ hours _____ G.P.M.

USE OF WATER Irrigation Temp. _____ °F. _____, 19

SOURCE OF INFORMATION GR-3940

DRILLER or DIGGER

ADDITIONAL DATA:

Log NA Water Level Measurements _____ Chemical Analysis _____ Aquifer Test _____

REMARKS: