

STATE ENGINEER
Salem, Oregon


Well Record LANE STATE WELL NO. 17/3W-19G
1124 COUNTY Lane
APPLICATION NO. GR-4084

OWNER: Mrs. Lois Pope MAILING ADDRESS: 145 Fir Acres Drive

LOCATION OF WELL: Owner's No. CITY AND STATE: Eugene, Oregon

SW $\frac{1}{4}$ NE $\frac{1}{4}$ Sec. 19 T. 17 N. S., R. 3 E. W., W.M.

Bearing and distance from section or subdivision corner 570 feet East and 900 feet North
from center of Section 19

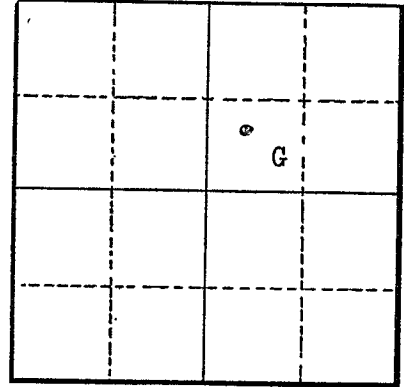

Altitude at well 150 feet

TYPE OF WELL: Drilled Date Constructed 5-1-54

Depth drilled 40 feet Depth cased

Section 19

CASING RECORD:

FINISH:

AQUIFERS:

WATER LEVEL:
15 feet

PUMPING EQUIPMENT: Type 2" Pacific H.P.
Capacity 180 G.P.M.

WELL TESTS:
Drawdown _____ ft. after _____ hours 180 G.P.M.
Drawdown _____ ft. after _____ hours _____ G.P.M.

USE OF WATER Irrigation Temp. _____ °F., 19

SOURCE OF INFORMATION GR-4059
DRILLER or DIGGER Wayne Hayes Eugene, Oregon

ADDITIONAL DATA:
Log (NA) Water Level Measurements _____ Chemical Analysis _____ Aquifer Test _____

REMARKS: