

OWNER: Fred C. Crafts


MAILING ADDRESS: 1127 Cal Young Rd.

LOCATION OF WELL: Owner's No.

CITY AND STATE: Eugene, Oregon

SW 1/4 NE 1/4 Sec. 19 T. 17 S., R. 3 W., W.M.

Bearing and distance from section or subdivision
corner 335 ft. N. then 171 ft. W. of the NW
corner of the Charles W. Young D.L.C. #33

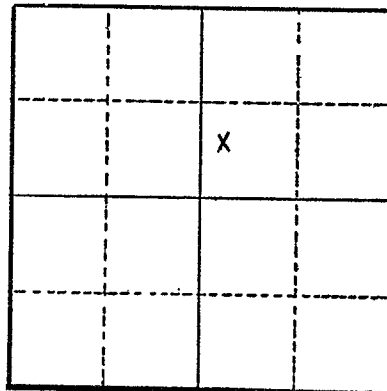

Section 19

Altitude at well

TYPE OF WELL: Drilled Date Constructed 1941

Depth drilled 40 ft. Depth cased 40 ft.

CASING RECORD:

2 inch casing set to 40 feet

FINISH:

AQUIFERS:

WATER LEVEL:

12 feet below surface

PUMPING EQUIPMENT: Type Jacuzzi 15PS

H.P. 1

Capacity 30 G.P.M.

WELL TESTS:

Drawdown 3 ft. ft. after hours 25 G.P.M.

Drawdown ft. after hours G.P.M.

USE OF WATER Irrigation Temp. °F. 19

SOURCE OF INFORMATION Well Registration Statement

DRILLER or DIGGER

ADDITIONAL DATA:

Log Water Level Measurements Chemical Analysis Aquifer Test

REMARKS:

Reg Cert.
3293