

STATE ENGINEER
Salem, Oregon

Well Record


STATE WELL NO. 17/3W-20L
COUNTY LANE
APPLICATION NO. GR-2640

OWNER: Oakway Golf Course By Ralph A. Hope MAILING ADDRESS: 700 Cal Young Road

LOCATION OF WELL: Owner's No. #2 CITY AND STATE: Eugene, Oregon

NE 1/4 SW 1/4 Sec. 20 T. 17 S., R. 3 W., W.M.

Bearing and distance from section or subdivision corner 1677' S. and 75' W. from NE corner C. W. Young DLC.

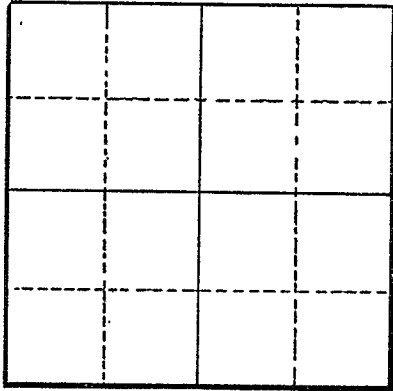

Section

Altitude at well

TYPE OF WELL: Drilled Date Constructed 1950

Depth drilled 25 Depth cased 25

CASING RECORD:

5-inch

FINISH:

Perforated from to 25

AQUIFERS:

WATER LEVEL:

3-feet

PUMPING EQUIPMENT: Type Centrifugal H.P. 20
Capacity 250 G.P.M.

WELL TESTS:

Drawdown ft. after hours Pumping 250 G.P.M.
Drawdown ft. after hours G.P.M.

USE OF WATER Irrigation Temp. °F., 19

SOURCE OF INFORMATION GR-2502

DRILLER or DIGGER Gardiner Well Drilling Co.

ADDITIONAL DATA:

Log Water Level Measurements Chemical Analysis Aquifer Test

REMARKS: