

STATE ENGINEER  
Salem, Oregon

# Well Record

STATE WELL NO. 17/3W-20M  
COUNTY LANE  
APPLICATION NO. GR-2641

11273

OWNER: Oakway Golf Course By Ralph A. Hope


MAILING ADDRESS: 700 Cal Young Road

LOCATION OF WELL: Owner's No.

CITY AND STATE: Eugene, Oregon

NW 1/4 SW 1/4 Sec. 20 T. 17 S., R. 3 W., W.M.

Bearing and distance from section or subdivision corner 1248' W. and 1041' S. from NE corner C.W. Young  
DLC.

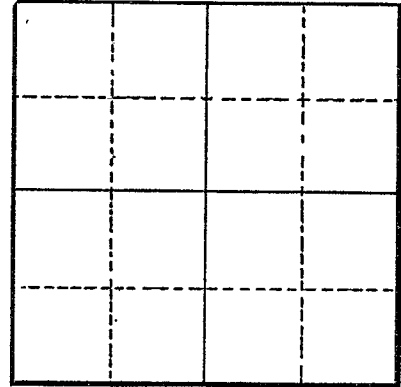

Section

Altitude at well

TYPE OF WELL: Dug Date Constructed 1950

Depth drilled 20 Depth cased

CASING RECORD:

FINISH:

AQUIFERS:

Gravel

WATER LEVEL:

3-feet

PUMPING EQUIPMENT: Type Centrifugal

H.P. 60

Capacity 900 G.P.M.

WELL TESTS:

Drawdown ft. after hours G.P.M.

Drawdown ft. after hours G.P.M.

USE OF WATER Irrigation

Temp. °F. 19

SOURCE OF INFORMATION GR-2503

DRILLER or DIGGER

ADDITIONAL DATA:

Log  Water Level Measurements  Chemical Analysis  Aquifer Test

REMARKS:

Gravel