

STATE ENGINEER
Salem, Oregon

Well Record **LANE** STATE WELL NO. 17/3W-22B
COUNTY Lane
11301 APPLICATION NO. GR-3989


OWNER: Chester A. and Leila P. Riebel MAILING ADDRESS: Route 2, Box 250
CITY AND STATE: Eugene, Oregon

LOCATION OF WELL: Owner's No. NW 1/4 NE 1/4 Sec. 22 T. 17 N. S., R. 3 E. W., W.M.

Bearing and distance from section or subdivision corner 1160 feet East and 60 feet South from NW Corner, Section 22

Altitude at well 400 feet

TYPE OF WELL: drilled Date Constructed Sept. 1, 1948
Depth drilled 58 feet Depth cased

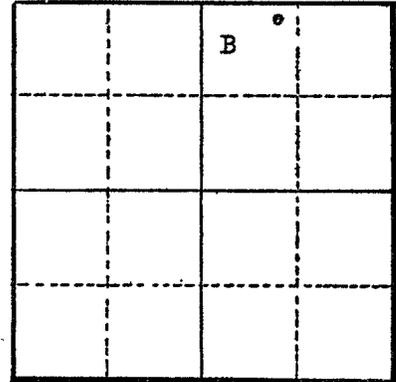

Section 22

CASING RECORD:

FINISH:

AQUIFERS:

WATER LEVEL:

21 feet

PUMPING EQUIPMENT: Type Jacuzzi Jet H.P.
Capacity 30 G.P.M.

WELL TESTS:

Drawdown ft. after hours G.P.M.
Drawdown ft. after hours G.P.M.

USE OF WATER Irrigation Temp. °F., 19

SOURCE OF INFORMATION GR-4015

DRILLER or DIGGER

ADDITIONAL DATA:

Log (NA) Water Level Measurements Chemical Analysis Aquifer Test

REMARKS: