

STATE ENGINEER  
Salem, Oregon

Well Record LANE STATE WELL NO. 17/3W - 22A(1)  
COUNTY LANE  
1130 APPLICATION NO. GR-2141

OWNER: Erven A. Schnetzky


MAILING ADDRESS: Rt. 2, Box 260-A

LOCATION OF WELL: Owner's No. #2

CITY AND STATE: Springfield, Oregon

NE 1/4 NE 1/4 Sec. 22 T. 17 N. S., R. 3 E. W., W.M.

Bearing and distance from section or subdivision corner 290' S. and 195' W.

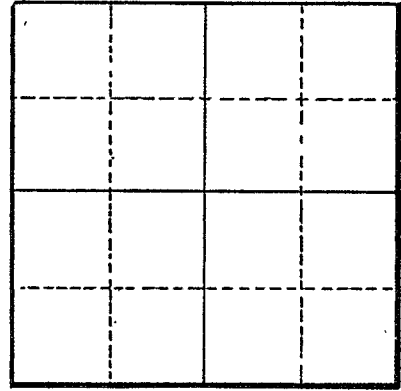

Section .....

Altitude at well .....

TYPE OF WELL: Driven Date Constructed 1946

Depth drilled 21 Depth cased 21

CASING RECORD:

(4) - 2-Inch

FINISH:

Perforations from 19 to 21

AQUIFERS:

WATER LEVEL:

16-feet

PUMPING EQUIPMENT: Type Deming Centrifugal

H.P. 15

Capacity 240 G.P.M.

WELL TESTS:

Drawdown ..... ft. after ..... hours ..... G.P.M.

Drawdown ..... ft. after ..... hours ..... G.P.M.

USE OF WATER Irrigation Temp. ..... °F. ...., 19

SOURCE OF INFORMATION GR-2054

DRILLER or DIGGER .....

ADDITIONAL DATA:

Log ..... Water Level Measurements ..... Chemical Analysis ..... Aquifer Test .....

REMARKS: