

STATE ENGINEER  
Salem, Oregon

Well Record **LANE** STATE WELL NO. 17/3W-22H  
COUNTY Lane  
GR- 1406 **111303** APPLICATION NO. GR- 1457

OWNER: George E. Simons


MAILING ADDRESS: Rt. 2, Box 243

LOCATION OF WELL: Owner's No. \_\_\_\_\_

CITY AND STATE: Eugene, Oregon

SE 1/4 NE 1/4 Sec. 22 T. 17 XX S., R. 3 XX W., W.M.

Bearing and distance from section or subdivision corner N28°30'W, 1440' from E 1/4 cor., Sec. 22

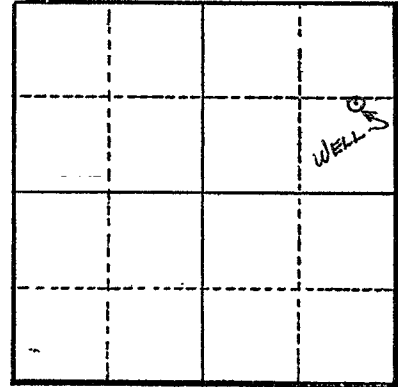

Section 22

Altitude at well 435'

TYPE OF WELL: Dug Date Constructed 1946

Depth drilled 27' Depth cased 27'

CASING RECORD:

30" concrete tile

FINISH:

AQUIFERS:

WATER LEVEL:

8'

PUMPING EQUIPMENT: Type F. M. 2" x 3" Cent. H.P. 10  
Capacity 250 G.P.M.

WELL TESTS:

Drawdown \_\_\_\_\_ ft. after \_\_\_\_\_ hours \_\_\_\_\_ G.P.M.  
Drawdown \_\_\_\_\_ ft. after \_\_\_\_\_ hours \_\_\_\_\_ G.P.M.

USE OF WATER Irrigation Temp. \_\_\_\_\_ °F., 19

SOURCE OF INFORMATION GR Record

DRILLER or DIGGER \_\_\_\_\_

ADDITIONAL DATA:

Log \_\_\_\_\_ Water Level Measurements \_\_\_\_\_ Chemical Analysis \_\_\_\_\_ Aquifer Test \_\_\_\_\_

REMARKS:

Log: Soil 0 to 6 ft.  
Gravel 6 to 27 ft.

Irrigation of 6 acres.