

STATE ENGINEER  
Salem, Oregon

# Well Record

STATE WELL NO. 17/3W-23 C  
COUNTY LANE  
APPLICATION NO. GR-2467

OWNER: Ebert B. Andrews


MAILING ADDRESS: Rt 24 Box 259 LANE 11342

LOCATION OF WELL: Owner's No. \_\_\_\_\_

CITY AND STATE: Eugene, Oregon

NE 1/4 NW 1/4 Sec. 23 T. 17 S., R. 3 W., W.M.

Bearing and distance from section or subdivision corner \_\_\_\_\_

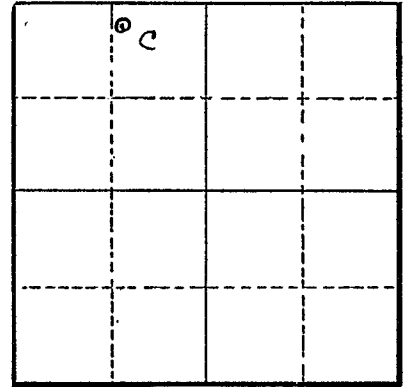

Section 23

Altitude at well \_\_\_\_\_

TYPE OF WELL: Driven Date Constructed 1953

Depth drilled 21' Depth cased \_\_\_\_\_

CASING RECORD:

FINISH:

AQUIFERS:

gravel, rock

WATER LEVEL:

12'

PUMPING EQUIPMENT: Type Fairbanks Morse H.P. 7 1/2  
Capacity 200 G.P.M.

WELL TESTS:

Drawdown \_\_\_\_\_ ft. after \_\_\_\_\_ hours \_\_\_\_\_ G.P.M.  
Drawdown \_\_\_\_\_ ft. after \_\_\_\_\_ hours \_\_\_\_\_ G.P.M.

USE OF WATER Irrigation Temp. \_\_\_\_\_ °F. \_\_\_\_\_, 19\_\_\_\_\_

SOURCE OF INFORMATION GR-3930

DRILLER or DIGGER \_\_\_\_\_

ADDITIONAL DATA:

Log  Water Level Measurements \_\_\_\_\_ Chemical Analysis \_\_\_\_\_ Aquifer Test \_\_\_\_\_

REMARKS:

River bottom land  
Hit gravel at about 14'  
hit solid rock at 21'