

STATE ENGINEER  
Salem, Oregon

Well Record **LANE** STATE WELL NO. 17/3W-23D  
COUNTY Lane  
1134 APPLICATION NO. GR-3405

OWNER: Virgil W. Rhoads


MAILING ADDRESS: Route 2, Box 256 A

LOCATION OF WELL: Owner's No.

CITY AND STATE: Eugene, Oregon

NW 1/4 NW 1/4 Sec. 23 T. 17 ~~N.~~ ~~E.~~  
S, R. 3 W., W.M.

Bearing and distance from section or subdivision  
corner 1010' E. and 1000' S.

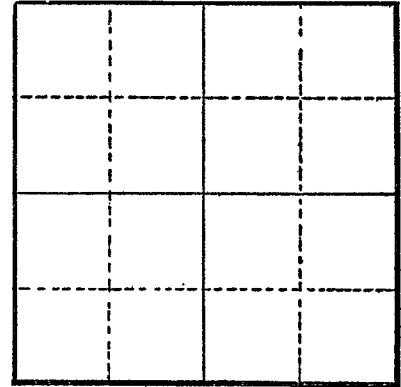

Section

Altitude at well

TYPE OF WELL: dug Date Constructed 1940

Depth drilled 24' Depth cased 24'

CASING RECORD:

6"

FINISH:

unknown (approx 18 3/8" holes/foot) from 18' to 24' level

AQUIFERS:

WATER LEVEL:

18' to 20'

PUMPING EQUIPMENT: Type Pacific H.P. 10  
Capacity 100-120 G.P.M.

WELL TESTS:

Drawdown ft. after hours pumping 100+ G.P.M.

Drawdown ft. after hours G.P.M.

USE OF WATER Irrigation Temp. °F., 19

SOURCE OF INFORMATION GR-3151

DRILLER or DIGGER

ADDITIONAL DATA:

Log Water Level Measurements Chemical Analysis Aquifer Test

REMARKS: