

STATE ENGINEER
Salem, Oregon


Well Record **LAME** STATE WELL NO. 17/3W-24J
11361 COUNTY Lane
APPLICATION NO. GR-3919

OWNER: Frank Bartholomew MAILING ADDRESS: Route 1, Box 38

LOCATION OF WELL: Owner's No. CITY AND STATE: Springfield, Oregon

NE 1/4 SE 1/4 Sec. 24 T. 17 S., R. 3 W., W.M.

Bearing and distance from section or subdivision
corner 3399.05 ft. N. & 1333.30 ft. E. of SW
Cor. of Felix Scott, Jr. DLC 51

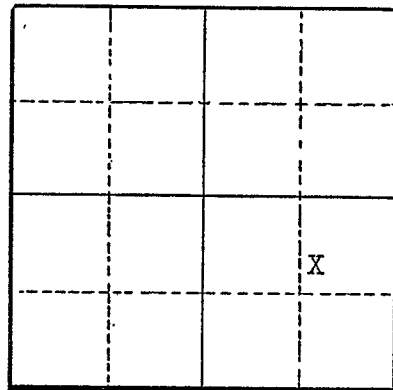

Section 24

Altitude at well

TYPE OF WELL: Driven Date Constructed Summer 1945

Depth drilled 22 ft. Depth cased 22 ft.

CASING RECORD:

2 inch casing set to 22 ft.

FINISH:

AQUIFERS:

WATER LEVEL:

18 feet below surface

PUMPING EQUIPMENT: Type Fairbanks Morse H.P. 7 1/2
Capacity G.P.M.

WELL TESTS:

Drawdown ft. after hours G.P.M.
Drawdown ft. after hours G.P.M.

USE OF WATER Irrigation Temp. °F. 19

SOURCE OF INFORMATION Well Registration Statement Cert. # GR-3556

DRILLER or DIGGER

ADDITIONAL DATA:

Log Water Level Measurements Chemical Analysis Aquifer Test

REMARKS: