

STATE ENGINEER
Salem, Oregon

Well Record *LANE* STATE WELL NO. *17/3W - 24J*
11362 COUNTY *LANE*
APPLICATION NO. *GR-2142*

OWNER: Marvin E. McLean


MAILING ADDRESS: Rt. 1, Box 34

LOCATION OF WELL: Owner's No. _____

CITY AND STATE: Springfield, Oregon

NE $\frac{1}{4}$ SE $\frac{1}{4}$ Sec. 24 T. 17 N. 3 E.
S., R. W., W.M.

Bearing and distance from section or subdivision
corner N. 89° 55' E. 2611.6' & N 5½' E. 4228.46'

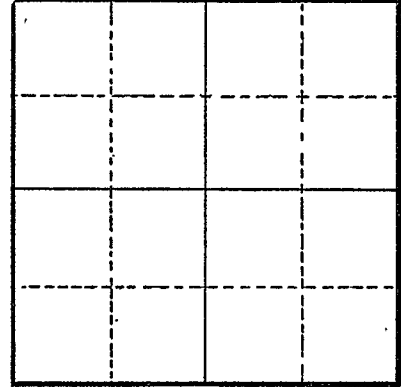

Section _____

Altitude at well _____

TYPE OF WELL: Driven Date Constructed 1947

Depth drilled 22 Depth cased 22

CASING RECORD:

3½-Inch

FINISH:

Perforations from 17 to 20

AQUIFERS:

WATER LEVEL:

14-feet

PUMPING EQUIPMENT: Type Allis Chalmers Centrifugal H.P. 5
Capacity 100 G.P.M.

WELL TESTS:

Drawdown _____ ft. after _____ hours _____ G.P.M.
Drawdown _____ ft. after _____ hours _____ G.P.M.

USE OF WATER Irrigation Temp. _____ °F. _____, 19_____

SOURCE OF INFORMATION GR-2055

DRILLER or DIGGER _____

ADDITIONAL DATA:

Log _____ Water Level Measurements _____ Chemical Analysis _____ Aquifer Test _____

REMARKS: