

STATE ENGINEER
Salem, Oregon


Well Record **LANE** STATE WELL NO. 17/3W-24J
COUNTY Lane
GR- 1369 **11363** APPLICATION NO. GR- 1415

OWNER: Nellie M. Scott MAILING ADDRESS: Rt. 1, Box 37

LOCATION OF WELL: Owner's No. #2 CITY AND STATE: Springfield, Oregon

NE 1/4 SE 1/4 Sec. 24 T. 17 S., R. 3 W., W.M.

Bearing and distance from section or subdivision corner 1300' S. & 10' E. from NW cor. DIC. #52

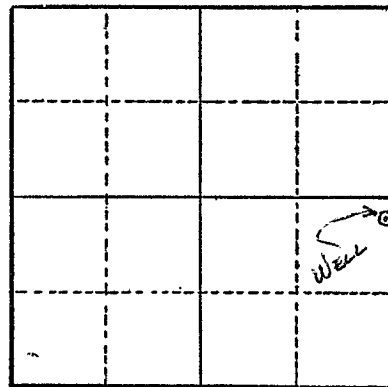

Section 24

Altitude at well _____

TYPE OF WELL: Driven Date Constructed 1948

Depth drilled 21' Depth cased 21'

CASING RECORD:

3"

FINISH:

Blown from 16' to 21'

AQUIFERS:

WATER LEVEL:

16'

PUMPING EQUIPMENT: Type Pacific 2" Cent. H.P. 5

Capacity 150 G.P.M.

WELL TESTS:

Drawdown _____ ft. after _____ hours _____ G.P.M.

Drawdown _____ ft. after _____ hours _____ G.P.M.

USE OF WATER Irrigation Temp. _____ °F. _____, 19____

SOURCE OF INFORMATION G. R. Record

DRILLER or DIGGER D. D. Dickenson

ADDITIONAL DATA:

Log N.A. Water Level Measurements _____ Chemical Analysis _____ Aquifer Test _____

REMARKS:

Irrigation of 5 acres.