

STATE ENGINEER
Salem, Oregon

Well Record **LANE** STATE WELL NO. 17/3W-28K
1142 COUNTY Lane
APPLICATION NO. GR-3552

OWNER: Dewey F. Ray


MAILING ADDRESS: Route 2, Box 73

LOCATION OF WELL: Owner's No.

CITY AND STATE: Eugene, Oregon

N. E.
NW 1/4 SE 1/4 Sec. 28 T. 17 S., R. 3 W., W.M.

Bearing and distance from section or subdivision
corner 2796 ft. N. and 191 ft. W. of the SE
corner of the Mahlon Harlow D.L.C. #57

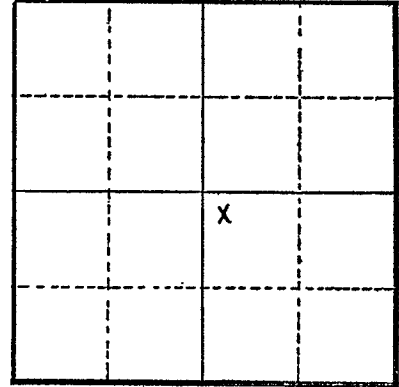

Section 28

Altitude at well

TYPE OF WELL: Dug Date Constructed 1946

Depth drilled 30 ft. Depth cased 30 ft.

CASING RECORD:

30 inch casing set to 30 feet

FINISH:

casing perforated from 27 feet to 30 feet

AQUIFERS:

WATER LEVEL:

15 feet below surface

PUMPING EQUIPMENT: Type Fairbanks Morse H.P. 20
Capacity 300 G.P.M.

WELL TESTS:

Drawdown 20 ft. after hours 300 G.P.M.

Drawdown ft. after hours G.P.M.

USE OF WATER Irrigation Temp. °F., 19

SOURCE OF INFORMATION Well Registration Statement

DRILLER or DIGGER

ADDITIONAL DATA:

Log Water Level Measurements Chemical Analysis Aquifer Test

REMARKS:

Log:
Loam first 15 ft. then rive bolders