

STATE ENGINEER  
Salem, Oregon

# Well Record

STATE WELL NO. 17/3W-28R  
COUNTY Lane  
APPLICATION NO. GR-3112

11/30

OWNER: Floyd L. Bailey


MAILING ADDRESS: Route 2, Box 96

LOCATION OF WELL: Owner's No.

CITY AND STATE: Springfield Oregon

SE 1/4 SE 1/4 Sec. 28 T. 17 N S, R. 3 W, W.M.

Bearing and distance from section or subdivision corner 950' N. and 200' W.

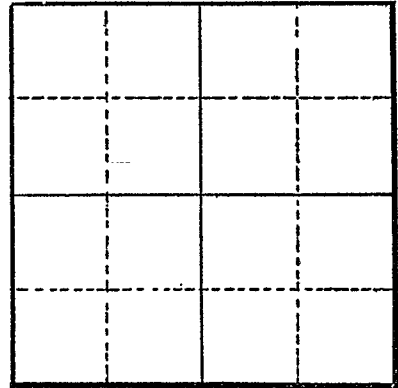

Section

Altitude at well

TYPE OF WELL: dug Date Constructed 1940

Depth drilled 22' Depth cased

### CASING RECORD:

### FINISH:

perforated check valve at bottom

### AQUIFERS:

soil  
gravel

### WATER LEVEL:

8-21'

PUMPING EQUIPMENT: Type Pacific

H.P. 1 1/2

Capacity 25 G.P.M.

### WELL TESTS:

Drawdown 2 ft. after hours pumping 30 G.P.M.

Drawdown ft. after hours G.P.M.

USE OF WATER Irrigation Temp. °F., 19.

SOURCE OF INFORMATION GR-2916

DRILLER or DIGGER dug by owner

### ADDITIONAL DATA:

Log  Water Level Measurements Chemical Analysis Aquifer Test

### REMARKS:

top soil 5'  
remainder of depth  
is gravel 17'