

STATE ENGINEER
Salem, Oregon

Well Record **LANE** STATE WELL NO. 17/3W-28R(1)
11433 COUNTY Lane
APPLICATION NO. GR-672

OWNER: Wilferd H. Cook MAILING ADDRESS: Rt. 2, Box 95

LOCATION OF WELL: Owner's No. 1 CITY AND STATE: Eugene, Oregon


SE 1/4 SE 1/4 Sec. 28 T. 17 S. R. 3 W., W.M.

Bearing and distance from section or subdivision corner 600' N. & 400' W. from SE cor. Sec. 28

Altitude at well 432 ft.

TYPE OF WELL: dug Date Constructed Oct. 1934

Depth drilled 32 ft. Depth cased 32 ft.

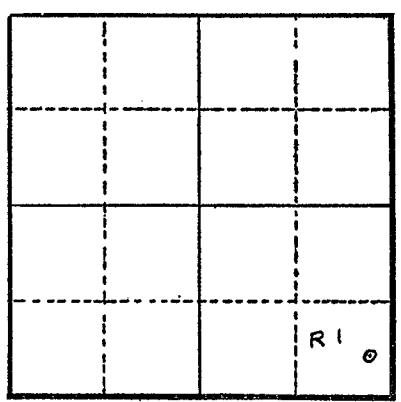

Section 28

CASING RECORD: 60 in. cement wall ground level to 6 ft.
30 in. tile 6 ft. to 22 ft.
4 in. pipe 20 ft. to 32 ft.

FINISH: 1/3 in. holes 20 ft. to 32 ft.

AQUIFERS:

WATER LEVEL: 17 ft.

PUMPING EQUIPMENT: Type Wesco 1 1/2 in. H.P. 1 1/2
Capacity G.P.M.

WELL TESTS:
Drawdown ft. after hours G.P.M.
Drawdown ft. after hours G.P.M.

USE OF WATER irrigation Temp. °F. 19

SOURCE OF INFORMATION GR-672

DRILLER or DIGGER

ADDITIONAL DATA:
Log X Water Level Measurements Chemical Analysis Aquifer Test

REMARKS:

