

STATE ENGINEER
Salem, Oregon

Well Record **LANE**

STATE WELL NO. 17/3W-28B
COUNTY **LANE**
APPLICATION NO. GR-2849

11437

OWNER: Frank B. Bloomer and Elsie H. Bloomer h/w


MAILING ADDRESS: 760 Harlow Road

LOCATION OF WELL: Owner's No.

CITY AND STATE: Eugene, Oregon

NW 1/4 NE 1/4 Sec. 28 T. 17 S., R. 3 W., W.M.

Bearing and distance from section or subdivision corner 344.74' S. 64° 47' W. from NE corner Mahlon H. Harlow DLC #57.

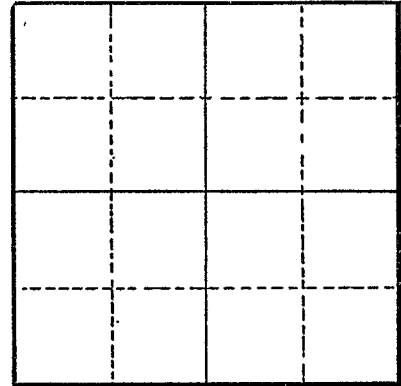

Section

Altitude at well

TYPE OF WELL: drilled Date Constructed 1947

Depth drilled 135 Depth cased

CASING RECORD:

4-inch

FINISH:

AQUIFERS:

WATER LEVEL:

65-feet

PUMPING EQUIPMENT: Type Peerless Jet Pump H.P. 1
Capacity 1000 G.P.M.

WELL TESTS:

Drawdown ft. after hours Pumping 15 G.P.M.
Drawdown ft. after hours G.P.M.

USE OF WATER irrigation Temp. °F., 19

SOURCE OF INFORMATION GR-2683

DRILLER or DIGGER

ADDITIONAL DATA:

Log Water Level Measurements Chemical Analysis Aquifer Test

REMARKS: