

STATE ENGINEER
Salem, Oregon

Well Record

STATE WELL NO. 17/3W-29A
COUNTY Lane
APPLICATION NO. GR-4023

11458

OWNER: Joseph A. Holaday


MAILING ADDRESS: 565 Coburg Road

LOCATION OF WELL: Owner's No. _____

CITY AND STATE: Oregon

NE 1/4 NE 1/4 Sec. 29 T. N. 17 S., R. 3 E. W., W.M.

Bearing and distance from section or subdivision corner 350 feet West and 600 feet South from the NE Corner, Section 29.

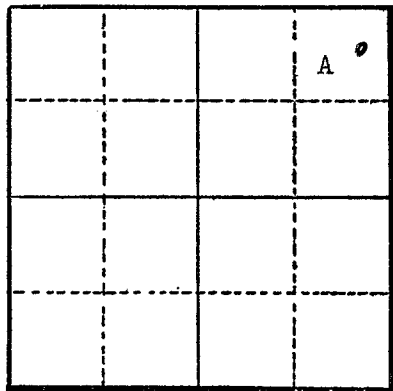

Section 29

Altitude at well _____

TYPE OF WELL: Drilled Date Constructed June, 1950

Depth drilled 26 feet Depth cased _____

CASING RECORD:

5-inch steel pipe galvanized

FINISH:

pipe with foot valve

AQUIFERS:

WATER LEVEL:

14 feet

PUMPING EQUIPMENT: Type Berkley Centrifugal H.P. _____
Capacity _____ G.P.M.

WELL TESTS:

Drawdown Unknown ft. after _____ hours 125 feet G.P.M. _____
Drawdown _____ ft. after _____ hours _____ G.P.M. _____

USE OF WATER Irrigation Temp. _____ °F. _____, 19____

SOURCE OF INFORMATION GR-4142

DRILLER or DIGGER Dell Page, Harrisburg

ADDITIONAL DATA:

Log (NA) Water Level Measurements _____ Chemical Analysis _____ Aquifer Test _____

REMARKS: