

STATE ENGINEER
Salem, Oregon


Well Record **LANE** STATE WELL NO. 17/3W-29F
COUNTY Lane
APPLICATION NO. GR-4018

OWNER: Wayne Hayes MAILING ADDRESS: 535 Cobury Rd.

LOCATION OF WELL: Owner's No. CITY AND STATE: Eugene, Oregon

SE 1/4 NW 1/4 Sec. 29 T. 17 S., R. 3 W., W.M.

Bearing and distance from section or subdivision corner 1320' S. & 614' W. of SE Cor. DLG 53

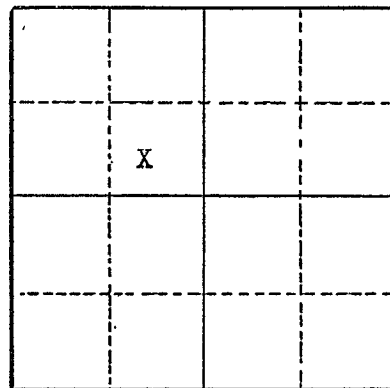

Section 29

Altitude at well

TYPE OF WELL: Driven Date Constructed 3/1/40

Depth drilled 28 ft. Depth cased 28 ft.

CASING RECORD:

2 inch casing set to 28 feet

FINISH:

about 100 1/4 inch holes from 26 to 28 feet

AQUIFERS:

WATER LEVEL:

16 feet below surface

PUMPING EQUIPMENT: Type Fairbanks Morse H.P. 5
Capacity 150 G.P.M.

WELL TESTS:

Drawdown 20 ft. after hours 150 G.P.M.

Drawdown ft. after hours G.P.M.

USE OF WATER Irrigation Temp. °F., 19

SOURCE OF INFORMATION Well Registration Statement Cert. # GR-3621

DRILLER or DIGGER Wayne Hayes

ADDITIONAL DATA:

Log Water Level Measurements Chemical Analysis Aquifer Test

REMARKS:

Log: 1 to 10 feet Sandy Loam
10 to 28 feet Water bearing gravel