

STATE ENGINEER
Salem, Oregon

Well Record **LANE** STATE WELL NO. 17/3W-31
COUNTY Lane
APPLICATION NO. GR-3608

OWNER: Eugene Branch The U.S. National
Bank of Portland


MAILING ADDRESS: P.O. Box 4410

LOCATION OF WELL: Owner's No.
Mulligans Addition

CITY AND STATE: Portland 8, Oregon

1/4 1/4 Sec. 31 T. 17 S., R. 3 W., W.M.

Bearing and distance from section or subdivision
corner 20' S. and 15' W.

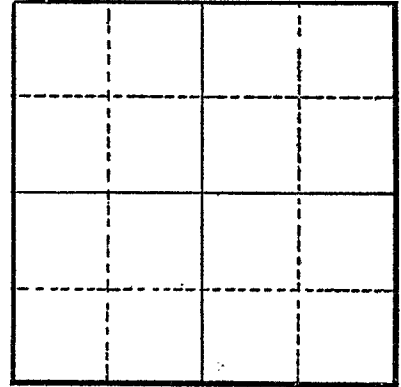

Section

Altitude at well

TYPE OF WELL: drilled Date Constructed 1941

Depth drilled 190' Depth cased 170'

CASING RECORD:

believed 8"

FINISH:

perforations "at 40'" and "at 55'"

AQUIFERS:

shell rock, sandstone, shale rock

WATER LEVEL:

15' static

PUMPING EQUIPMENT: Type Jacuzzi H.P. 7 1/2
Capacity 110 G.P.M.

WELL TESTS:

Drawdown ft. after hours pumping 60 G.P.M.

Drawdown ft. after hours G.P.M.

USE OF WATER air-conditioning Temp. °F., 19

SOURCE OF INFORMATION GR-3156

DRILLER or DIGGER

ADDITIONAL DATA:

Log Water Level Measurements Chemical Analysis Aquifer Test

REMARKS:

no information	0	60
Shell rock	60	180
Sandstone	180	189
Shale rock	189	190