

STATE ENGINEER
Salem, Oregon

Well Record

STATE WELL NO. 17/3W-33D
COUNTY Lane
APPLICATION NO. GR-1473

GR- 1422

11538

OWNER: Ernest L. Peugh

MAILING

ADDRESS: P. O. Box 129

LOCATION OF WELL: Owner's No.


CITY AND

STATE: Eugene, Oregon

NW 1/4 NW 1/4 Sec. 33 T. 17 S., R. 3 W., W.M.

Bearing and distance from section or subdivision

corner N. 89°48'E. 355' & 335' S. from NW cor. Sec. 33

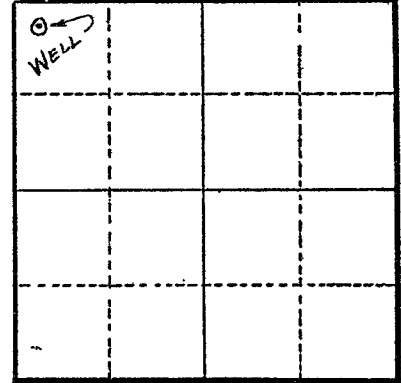

Section 33

Altitude at well 400'

TYPE OF WELL: Dug Date Constructed 1938

Depth drilled 16' Depth cased 16'

CASING RECORD:

36" concrete

FINISH:

AQUIFERS:

WATER LEVEL:

12'

PUMPING EQUIPMENT: Type Century 2" Cent.

H.P. 5

Capacity G.P.M.

WELL TESTS:

Drawdown 0.5 ft. after 150 hours G.P.M.

Drawdown ft. after hours G.P.M.

USE OF WATER Irrigation Temp. °F., 19

SOURCE OF INFORMATION GR Record

DRILLER or DIGGER

ADDITIONAL DATA:

Log Water Level Measurements Chemical Analysis Aquifer Test

REMARKS:

Log: Soil 0 to 8'
River gravel 8' to 16'

Irrigation of 13.7 acres