


STATE ENGINEER  
Salem, Oregon

Well Record **LANE** STATE WELL NO. 17/3W-36Q  
11581 COUNTY Lane  
APPLICATION NO. GR-3775

OWNER: The Booth-Kelly Lumber Company MAILING ADDRESS: P.O. Box 248

LOCATION OF WELL: Owner's No. CITY AND STATE: Springfield, Oregon

SW 1/4 SE 1/4 Sec. 36 T. 17 S., R. 3 W., W.M.  
Bearing and distance from section or subdivision  
corner 1270 ft. N. 63° 44' E. from (stone)  
reentrant angle Isaac Briggs DIC # 83

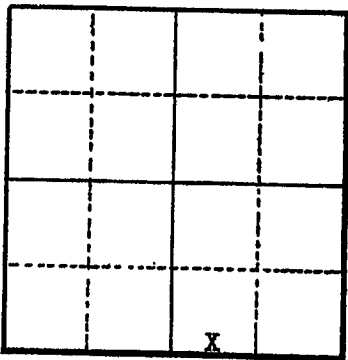

Altitude at well

TYPE OF WELL: Drilled Date Constructed Aug. 1949

Depth drilled 61 feet Depth cased 61 feet

Section 36

CASING RECORD:

4 inch casing set to 61 feet

FINISH:

AQUIFERS:

WATER LEVEL:

9 feet below surface

PUMPING EQUIPMENT: Type Berkeley Model 3-70 H.P. 3  
Capacity 500 G.P.M.

WELL TESTS:

Drawdown free flow ft. after 300 hours G.P.M.  
Drawdown # 25 press ft. after 250 hours G.P.M.

USE OF WATER Industrial Temp. °F. 19

SOURCE OF INFORMATION Well Registration Statement

DRILLER or DIGGER G. E. Gordinier

ADDITIONAL DATA:

Log X Water Level Measurements Chemical Analysis Aquifer Test

REMARKS:

2433

