

STATE ENGINEER
Salem, Oregon


Well Record **LANE** STATE WELL NO. 17/4W-1C
COUNTY Lane
APPLICATION NO. GR-3621

OWNER: Page Walton MAILING ADDRESS: 1225 Beacon Drive

LOCATION OF WELL: Owner's No. CITY AND STATE: Eugene, Oregon

NE 1/4 NW 1/4 Sec. 1 T. 17 S., R. 4 W., W.M.

Bearing and distance from section or subdivision corner From SW corner Sec. 36, 1940 S. 89° E.
to well

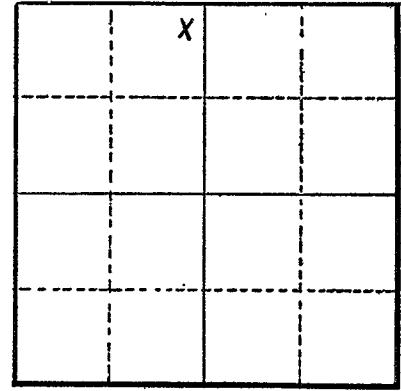

Section 1

Altitude at well _____

TYPE OF WELL: Driven Date Constructed Mar., 1954

Depth drilled 26 feet Depth cased 21 feet

CASING RECORD:

6 inch casing set to 21 feet

FINISH:

42 5/16 diameter holes per foot

AQUIFERS:

WATER LEVEL:

9 feet below surface

PUMPING EQUIPMENT: Type Cornell gasoline H.P. 25
Capacity 200 G.P.M.

WELL TESTS:

Drawdown 1.00 ft. after _____ hours 200 G.P.M.
Drawdown _____ ft. after _____ hours _____ G.P.M.

USE OF WATER Irrigation Temp. _____ °F., 19____

SOURCE OF INFORMATION Well Registration Statement

DRILLER or DIGGER D. D. Dickinson

ADDITIONAL DATA:

Log _____ Water Level Measurements _____ Chemical Analysis _____ Aquifer Test _____

REMARKS: