

STATE ENGINEER
Salem, Oregon

Well Record LANE STATE WELL NO. 17/4W-1C
COUNTY Lane
GR- 1669 11605 APPLICATION NO. GR- 1720

OWNER: Lon A. Hawkins


MAILING ADDRESS: 1850 Beacon Dr.

LOCATION OF WELL: Owner's No. _____

CITY AND STATE: Eugene, Oregon

NE 1/4 NW 1/4 Sec. 1 T. 17 S., R. 4 W., W.M.

Bearing and distance from section or subdivision corner 2640' S. 64° E. from NW cor. Sec. 1

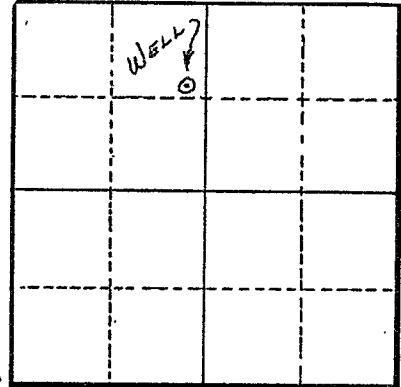

Altitude at well 376'

TYPE OF WELL: Driven Date Constructed 1942 Prior to _____

Depth drilled 20' Depth cased 20'

Section 1

CASING RECORD:

3"

FINISH:

24" of tip of pipe perforated with 1/2" holes

AQUIFERS:

Sand & fine gravel

WATER LEVEL:

9'

PUMPING EQUIPMENT: Type F. M. 2" x 1 1/2" Cent.
Capacity 120 G.P.M.

H.P. 5

WELL TESTS:

Drawdown _____ ft. after _____ hours _____ G.P.M.

Drawdown _____ ft. after _____ hours _____ G.P.M.

USE OF WATER Irrigation Temp. _____ °F. _____, 19____

SOURCE OF INFORMATION GR Record

DRILLER or DIGGER _____

ADDITIONAL DATA:

Log N.A. Water Level Measurements _____ Chemical Analysis _____ Aquifer Test _____

REMARKS:

Irrigation of 16.28 acres.