

STATE ENGINEER
Salem, Oregon

Well Record **LANE** STATE WELL NO. 17/4W-1E
COUNTY Lane
APPLICATION NO. GR-3326
11606

OWNER: Clarence E. Waldahl

MAILING ADDRESS: 695 River Loop 2

LOCATION OF WELL: Owner's No.

CITY AND STATE: Oregon

SW 1/4 NW 1/4 Sec. 1 T. 17 N. S., R. 4 E. W., W.M.

Bearing and distance from section or subdivision


corner 89° 53' East 30 feet 24.95 chains North
of NW Corner, B. W. Poindexter Land Claim No. 57.

840' east & 100' north from W 1/4 Corner, Sec. 1

Altitude at well

TYPE OF WELL: Drilled Date Constructed 1950

Depth drilled 15 feet Depth cased

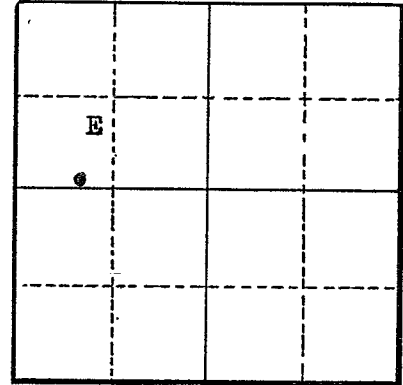

Section 1

CASING RECORD:

2 in pipe

FINISH:

AQUIFERS:

WATER LEVEL:

PUMPING EQUIPMENT: Type Jacuzzi H.P.
Capacity 15 G.P.M.

WELL TESTS:

Drawdown ft. after hours G.P.M.
Drawdown ft. after hours G.P.M.

USE OF WATER Irrigation Temp. °F. 19

SOURCE OF INFORMATION GR-4098

DRILLER or DIGGER

ADDITIONAL DATA:

Log (NA) Water Level Measurements Chemical Analysis Aquifer Test

REMARKS: