

STATE ENGINEER  
Salem, Oregon

# Well Record

STATE WELL NO. 17/4W-1E  
COUNTY Lane  
APPLICATION NO. GR-3325

OWNER: Elmer E. Johnson

MAILING ADDRESS: 715 River Loop #2


LOCATION OF WELL: Owner's No.

CITY AND STATE: Eugene, Oregon

SW 1/4 NW 1/4 Sec. 1 T. 17 N. S. R. 4 W., W.M.

Bearing and distance from section or subdivision

corner 2230' S. and 910' E.

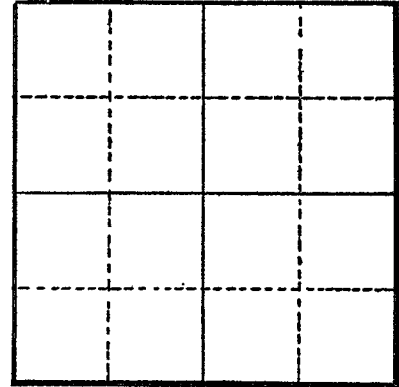

Section

Altitude at well

TYPE OF WELL: drilled Date Constructed 1948

Depth drilled 28' Depth cased 28'

### CASING RECORD:

6"

### FINISH:

3' of 6" regular perforated well pipe from 25 to 28

### AQUIFERS:

silt loam, sand, gravel

### WATER LEVEL:

14'

PUMPING EQUIPMENT: Type Fairbanks Morse

H.P. 7 1/2

Capacity 400 G.P.M.

### WELL TESTS:

Drawdown 2 ft. after hours pumping 480 G.P.M.

Drawdown ft. after hours G.P.M.

USE OF WATER Irrigation

Temp. °F. 19

SOURCE OF INFORMATION GR-3083

DRILLER or DIGGER

### ADDITIONAL DATA:

Log  Water Level Measurements  Chemical Analysis  Aquifer Test

### REMARKS:

silt loam	8	8
sand	4	12
sand & gravel	16	28