

STATE ENGINEER
Salem, Oregon

Well Record LANE

STATE WELL NO. 17/4W-1F(1)
COUNTY Lane
APPLICATION NO. GR-1247

GR- 1204

11608


OWNER: William E. Barbee

MAILING ADDRESS: 941 Riverloop #2

LOCATION OF WELL: Owner's No. #2

CITY AND STATE: Eugene, Oregon

SE 1/4 NW 1/4 Sec. 1 T. 17 S, R. 4 W., W.M.
Bearing and distance from section or subdivision
corner 1815' E. from W⁴ cor. of Sec. 1

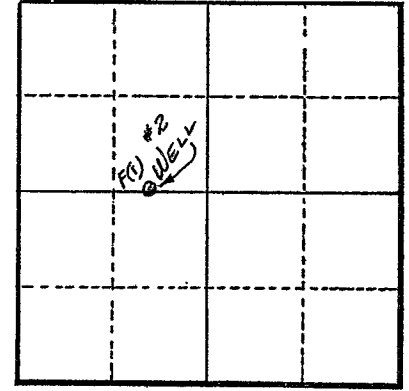

Section 1

Altitude at well 400 ft.

TYPE OF WELL: Driven Date Constructed 1941

Depth drilled 20 ft. Depth cased 20 ft.

CASING RECORD:

2- 2inch pipes driven 8 ft. apart.

FINISH:

Perforated (3/8 x 6 in.) from 16 to 20 ft.

AQUIFERS:

WATER LEVEL:

5 ft.

PUMPING EQUIPMENT: Type F. M. 2 in. Cent. H.P. 5
Capacity 140 G.P.M.

WELL TESTS:

Drawdown _____ ft. after _____ hours _____ G.P.M.
Drawdown _____ ft. after _____ hours _____ G.P.M.

USE OF WATER Irrigation Temp. _____ °F. _____, 19

SOURCE OF INFORMATION G. R. Record

DRILLER or DIGGER

ADDITIONAL DATA:

Log N.A. Water Level Measurements _____ Chemical Analysis _____ Aquifer Test _____

REMARKS:

Irrigation of 8.4 acres.