

STATE ENGINEER
Salem, Oregon

Well Record

LANE
11609

STATE WELL NO. 17/44-1F(2)
COUNTY Lane
APPLICATION NO. GR-1209

GR- 1169

OWNER: A. J. McManus

MAILING

ADDRESS: 991 River Loop #2

LOCATION OF WELL: Owner's No.


CITY AND

STATE: Eugene, Oregon

SE 1/4 NW 1/4 Sec. 1 T. 17 S, R. 4 W, W.M.

Bearing and distance from section or subdivision

corner 9.5 ch. N. & 28 ch. E. from W. cor. Sec. 1.

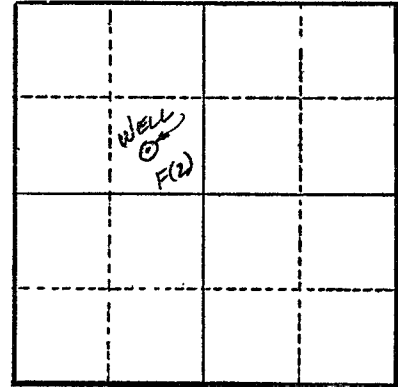

Altitude at well 375 ft.

TYPE OF WELL: Driven Date Constructed 1952

Depth drilled 21 ft. Depth cased 20 ft.

Section 1

CASING RECORD:

4 in. from 0 to 20 ft.

FINISH:

Perforated with 1/2 in. holes (3 x 3 in.) from 17 to 20 ft.

AQUIFERS:

WATER LEVEL:

8 ft.

PUMPING EQUIPMENT: Type A.C. 3 x 4 in.

H.P. 15

Capacity G.P.M.

WELL TESTS:

Drawdown ft. after hours G.P.M.

Drawdown ft. after hours G.P.M.

USE OF WATER Irrigation Temp. °F. 19

SOURCE OF INFORMATION G. R. Record

DRILLER or DIGGER D. D. Dickenson

ADDITIONAL DATA:

Log N.A. Water Level Measurements Chemical Analysis Aquifer Test

REMARKS:

Irrigation of 18 acres.