

STATE ENGINEER
Salem, Oregon

Well Record ~~LANE~~

STATE WELL NO. 17/4W-1G
COUNTY Lane
APPLICATION NO. GR-588

GR- 1569

11610

OWNER: Allen Lee Baird


MAILING ADDRESS: 1701 River Loop #1

LOCATION OF WELL: Owner's No.

CITY AND STATE: Eugene, Oregon

SW 1/4 NE 1/4 Sec. 1 T. 17 S., R. 4 W., W.M.

Bearing and distance from section or subdivision corner 1948 ch. N. 1°18'E. from NE cor. of DIC #57

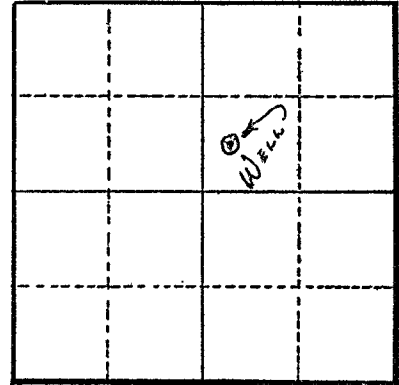

Section 1

Altitude at well 360

TYPE OF WELL: Drilled Date Constructed 1940

Depth drilled 20' Depth cased 20'

CASING RECORD:

1 1/2"

FINISH:

AQUIFERS:

WATER LEVEL:

17'

PUMPING EQUIPMENT: Type F. M. 1 1/2" Cent. H.P. 3
Capacity 320 G.P.M.

WELL TESTS:

Drawdown ft. after hours G.P.M.
Drawdown ft. after hours G.P.M.

USE OF WATER Irrigation Temp. °F. 19

SOURCE OF INFORMATION GR Record

DRILLER or DIGGER

ADDITIONAL DATA:

Log N.A. Water Level Measurements Chemical Analysis Aquifer Test

REMARKS:

Irrigation of 6 acres.