

STATE ENGINEER
Salem, Oregon


Well Record **LANE** STATE WELL NO. 17/4N-1G
11611 COUNTY LANE
APPLICATION NO. GR-2611

OWNER: Frank X. Gallagher MAILING ADDRESS: 1900 Beacon Drive

LOCATION OF WELL: Owner's No. CITY AND STATE: Eugene, Oregon

SW NE 1 17 4 E
1/4 1/4 Sec. T. S., R. W., W.M.

Bearing and distance from section or subdivision corner 2960' E. & 1461' S.

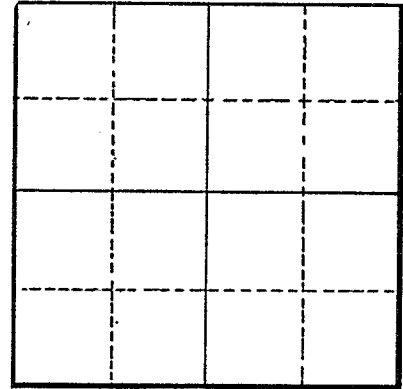

Section

Altitude at well

TYPE OF WELL: Driven Date Constructed 1946

Depth drilled 18 Depth cased 18

CASING RECORD:

4-inch

FINISH:

1/4" round - many from 14 to 18

AQUIFERS:

Soil, sand and gravel

WATER LEVEL:

PUMPING EQUIPMENT: Type Centrifugal H.P.
Capacity 200 G.P.M.

WELL TESTS:

Drawdown ft. after hours G.P.M.
Drawdown ft. after hours G.P.M.

USE OF WATER Irrigation Temp. °F., 19

SOURCE OF INFORMATION GR-2478

DRILLER or DIGGER

ADDITIONAL DATA:

Log Water Level Measurements Chemical Analysis Aquifer Test

REMARKS:

Soil 6'
Sand and gravel 12'