

STATE ENGINEER
Salem, Oregon

Well Record **LANE** STATE WELL NO. 17/4W-1G
GR- 1203 COUNTY Lane
16/2 APPLICATION NO. GR- 1246

OWNER: William E. Barbee


MAILING ADDRESS: 941 Riverloop #2

LOCATION OF WELL: Owner's No. #1

CITY AND STATE: Eugene, Oregon

SW 1/4 NE 1/4 Sec. 1 T. 17 S, R. 4 W., W.M.

Bearing and distance from section or subdivision corner 363' N. & 2277' W. from E1/4 cor. Sec. 1.

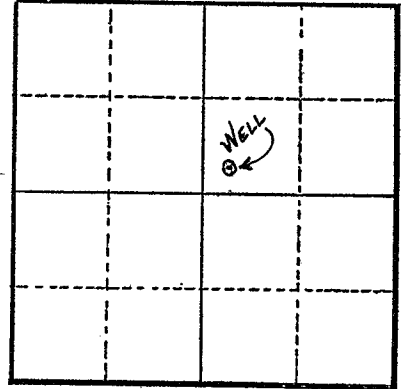

Section 1

Altitude at well 400 ft.

TYPE OF WELL: Driven Date Constructed 1952

Depth drilled 20 ft. Depth cased 20 ft.

CASING RECORD:

4 inch

FINISH:

Perforated with 3/8 x 6 in. slots from 16 to 20 ft.

AQUIFERS:

WATER LEVEL:

5 ft.

PUMPING EQUIPMENT: Type A.C. Cent. H.P. 7 1/2
Capacity 210 G.P.M.

WELL TESTS:

Drawdown _____ ft. after _____ hours _____ G.P.M.
Drawdown _____ ft. after _____ hours _____ G.P.M.

USE OF WATER Irrigation Temp. _____ °F., 19

SOURCE OF INFORMATION G.E. Record

DRILLER or DIGGER _____

ADDITIONAL DATA:

Log N.A. Water Level Measurements _____ Chemical Analysis _____ Aquifer Test _____

REMARKS:

Irrigation of 10 acres.