

STATE ENGINEER
Salem, Oregon

Well Record **LANE** STATE WELL NO. 17/4W-1J
11613 COUNTY Lane
APPLICATION NO. GR-4059

OWNER: Wallace Whiteley


MAILING ADDRESS: 1440 River Loop I

LOCATION OF WELL: Owner's No.

CITY AND STATE: Eugene, Oregon

NE 1/4 SE 1/4 Sec. 1 T. 17 S., R. 4 W., W.M.

Bearing and distance from section or subdivision corner 2050' N. & 1160' W. from SE cor. Sec. 1

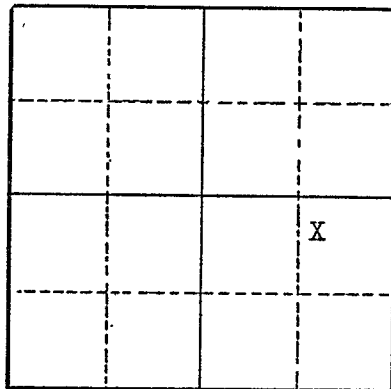

Section 1

Altitude at well

TYPE OF WELL: Driven Date Constructed 1948

Depth drilled 21 ft. Depth cased 21 ft.

CASING RECORD:

2 inch casing set to 21 feet

FINISH:

shot end

AQUIFERS:

WATER LEVEL:

15 feet below surface

PUMPING EQUIPMENT: Type Fairbanks Morse centrifugal H.P. 3
Capacity 150 G.P.M.

WELL TESTS:

Drawdown ft. after hours G.P.M.

Drawdown ft. after hours G.P.M.

USE OF WATER Irrigation Temp. °F. 19
SOURCE OF INFORMATION Well Registration Statement Cert. # GR-3659

DRILLER or DIGGER

ADDITIONAL DATA:

Log Water Level Measurements Chemical Analysis Aquifer Test

REMARKS: