

STATE ENGINEER  
Salem, Oregon

Well Record **LANE** STATE WELL NO. 17/4W-1K  
COUNTY Lane  
APPLICATION NO. GR-2796

OWNER: Brodie E. Brumley


MAILING ADDRESS: 50 Chapman Drive

LOCATION OF WELL: Owner's No.

CITY AND STATE: Eugene, Oregon

NW 1/4 SE 1/4 Sec. 1 T. 17 N. S. R. 4 W., W.M.

Bearing and distance from section or subdivision corner 1655 feet West and 1350 feet North from the SE Corner, Section 1

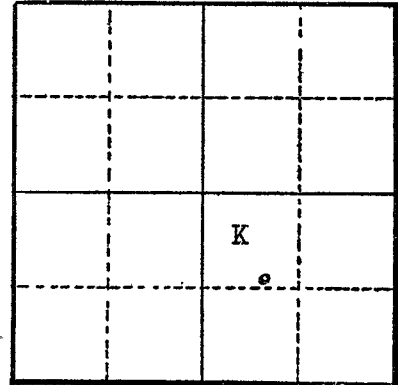

Altitude at well 450 feet

TYPE OF WELL: Driven Date Constructed April 1946

Depth drilled 20 feet Depth cased 20

Section 1

CASING RECORD:

FINISH:

Pointed pipe with few holes in lower end of pipe

AQUIFERS:

gravel, and sand

WATER LEVEL:

6 or 8 feet

PUMPING EQUIPMENT: Type Fairbank Morse 1 1/2" intake 1 1/4" outlet H.P. 3  
Capacity 700 G.P.M.

WELL TESTS:

Drawdown ft. after hours 3200 gallons per hour G.P.M.  
Drawdown ft. after hours G.P.M.

USE OF WATER Garden & pasture Temp. °F. 19

SOURCE OF INFORMATION GR-4036

DRILLER or DIGGER D. D. Dickenson 1280 River Road, Eugene, Oregon

ADDITIONAL DATA:

Log X Water Level Measurements Chemical Analysis Aquifer Test

REMARKS:

River loam round gravel and sand 0 20 20