

STATE ENGINEER  
Salem, Oregon

# Well Record

LANE  
11615

STATE WELL NO. 17/4W-1K  
COUNTY LANE  
APPLICATION NO. GR-2371

OWNER: James B. Chapman


MAILING ADDRESS: 51 Chapman Dr.

LOCATION OF WELL: Owner's No.

CITY AND STATE: Eugene, Oregon

NW ¼ SE ¼ Sec. 1 T. 17 N S., R. 4 W., W.M.

Bearing and distance from section or subdivision corner 3300.28' S. and 428' E.

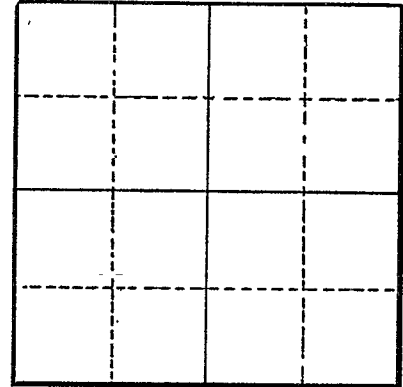

Section

Altitude at well

TYPE OF WELL: Driven Date Constructed 1928

Depth drilled 20 Depth cased 20

### CASING RECORD:

2-inch

### FINISH:

Holes Drilled from 16 to 20

### AQUIFERS:

### WATER LEVEL:

12-feet

PUMPING EQUIPMENT: Type Fairbanks Centrifugal H.P. 5  
Capacity 120 G.P.M.

### WELL TESTS:

Drawdown ft. after hours G.P.M.

Drawdown ft. after hours G.P.M.

USE OF WATER Irrigation Temp. °F. 19

SOURCE OF INFORMATION GR-2252

DRILLER or DIGGER Self

### ADDITIONAL DATA:

Log Water Level Measurements Chemical Analysis Aquifer Test

### REMARKS: