


STATE ENGINEER
Salem, Oregon

Well Record **LANE** STATE WELL NO. 17/4W-1K(1)
COUNTY Lane
GR- 1024 **11616** APPLICATION NO. GR- 1062

OWNER: Robert D. Maclay MAILING ADDRESS: 1250 River Loop

LOCATION OF WELL: Owner's No. #1 CITY AND STATE: Eugene, Oregon

NW 1/4 SW 1/4 Sec. 1 T. 17 S., R. 4 W., W.M.
Bearing and distance from section or subdivision
corner 910' S & 115' W. from NE cor. of the
Poindexter DIC #57.

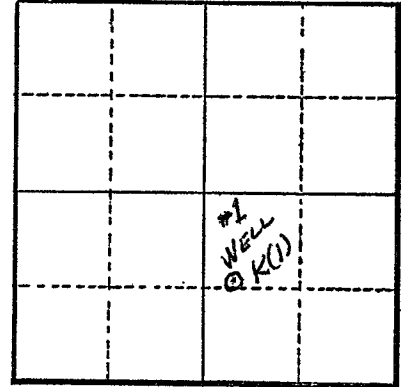

Section 1

Altitude at well 374 ft.

TYPE OF WELL: Driven Date Constructed 1940

Depth drilled 20 ft. Depth cased 20 ft.

CASING RECORD:

2- 2 1/2" pipes

FINISH:

AQUIFERS:

WATER LEVEL:

10 inch

PUMPING EQUIPMENT: Type Cent. H.P. 7
Capacity _____ G.P.M.

WELL TESTS:

Drawdown _____ ft. after _____ hours _____ G.P.M.

Drawdown _____ ft. after _____ hours _____ G.P.M.

USE OF WATER Irrigation Temp. _____ °F., 19_____

SOURCE OF INFORMATION G.R. Record

DRILLER or DIGGER _____

ADDITIONAL DATA:

Log N.A. Water Level Measurements _____ Chemical Analysis _____ Aquifer Test _____

REMARKS:

Irrigation of 13 acres.