

STATE ENGINEER
Salem, Oregon

Well Record

LANE
11617

STATE WELL NO. 17/4W-11(1)
COUNTY Lane
APPLICATION NO. GR-1195

GR- 1156

OWNER: Arthur L. Baker


MAILING ADDRESS: 980 River Loop

LOCATION OF WELL: Owner's No.

CITY AND STATE: Eugene, Oregon

NE 1/4 SW 1/4 Sec. 1 T. 17 S., R. 4 W., W.M.

Bearing and distance from section or subdivision
corner 35.5 ch. N. & 31 ch. E. from SW cor. Sec. 1.

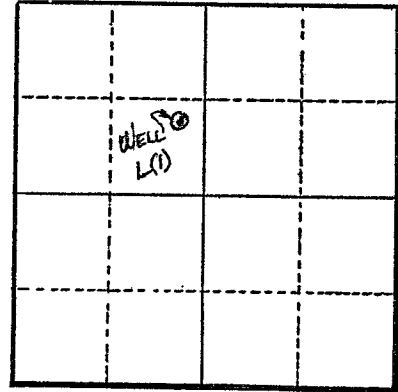

Section 1

Altitude at well 388 ft.

TYPE OF WELL: Drilled Date Constructed 1930

Depth drilled 22 ft. Depth cased 22 ft.

CASING RECORD:

3 inch

FINISH:

AQUIFERS:

WATER LEVEL:

8 ft.

PUMPING EQUIPMENT: Type Cent.

H.P. 3 1/2

Capacity 50 G.P.M.

WELL TESTS:

Drawdown _____ ft. after _____ hours _____ G.P.M.

Drawdown _____ ft. after _____ hours _____ G.P.M.

USE OF WATER Irrigation Temp. _____ °F. _____ 19

SOURCE OF INFORMATION G. R. Record

DRILLER or DIGGER

ADDITIONAL DATA:

Log N.A. Water Level Measurements _____ Chemical Analysis _____ Aquifer Test _____

REMARKS:

Irrigation of 8 acres.