

STATE ENGINEER
Salem, Oregon

Well Record

STATE WELL NO. 17/4W-11
COUNTY Lane
APPLICATION NO. GR-1406

GR-1361

11619

OWNER: James H. Denny


MAILING ADDRESS: 1050 River Loop #2

LOCATION OF WELL: Owner's No.

CITY AND STATE: Eugene, Oregon

NE ¼ SW ¼ Sec. 1 T. 17 S., R. 4 W., W.M.

Bearing and distance from section or subdivision corner 852.2' W. & 422' S. from NE cor. DIC #57.

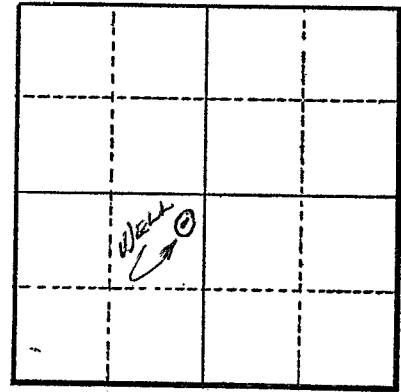

Section 1

Altitude at well

TYPE OF WELL: Driven Date Constructed 1943

Depth drilled 16 ft. Depth cased 16 ft.

CASING RECORD:

1 1/2 inch

FINISH:

Sand point

AQUIFERS:

Gravels

WATER LEVEL:

12 ft.

PUMPING EQUIPMENT: Type Pacific 1 1/4 in.

H.P. 2

Capacity 64 G.P.M.

WELL TESTS:

Drawdown _____ ft. after _____ hours _____ G.P.M.

Drawdown _____ ft. after _____ hours _____ G.P.M.

USE OF WATER Irrigation Temp. _____ °F. _____ 19

SOURCE OF INFORMATION G. R. Record

DRILLER or DIGGER

ADDITIONAL DATA:

Log N.A. Water Level Measurements _____ Chemical Analysis _____ Aquifer Test _____

REMARKS:

Irrigation of 4 acres.