

STATE ENGINEER
Salem, Oregon

Well Record **LANE** STATE WELL NO. 17/~~44~~-1M
11620 COUNTY LANE
~~APPLICATION NO.~~ GR-2132

OWNER: Ralph E & Grace A. Clark

MAILING ADDRESS: 810 River Loop


LOCATION OF WELL: Owner's No. _____

CITY AND STATE: Eugene, Oregon

NW 1/4 SW 1/4 Sec. 1 T. 17 S., R. 4 W., W.M.

Bearing and distance from section or subdivision

corner 232615' E & 300' S of NW corner

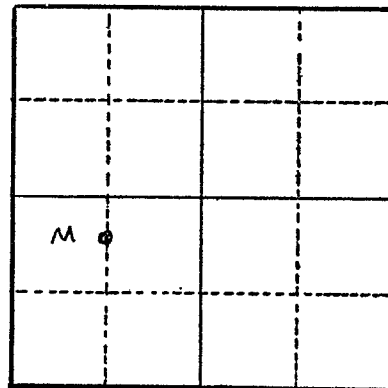

Section 1

Altitude at well _____

TYPE OF WELL: DRIVEN Date Constructed 1935

Depth drilled 20' Depth cased 20'

CASING RECORD:

2 1/2-inch

FINISH:

Perforated

AQUIFERS:

WATER LEVEL:

15'

PUMPING EQUIPMENT: Type Gould Cent

H.P. 2 1/4

Capacity 144 G.P.M.

WELL TESTS:

Drawdown _____ ft. after _____ hours _____ G.P.M.

Drawdown _____ ft. after _____ hours _____ G.P.M.

USE OF WATER Irrigation

Temp. _____ °F., 19 _____

SOURCE OF INFORMATION GR-3893

DRILLER or DIGGER Owner

ADDITIONAL DATA:

Log NA Water Level Measurements _____ Chemical Analysis _____ Aquifer Test _____

REMARKS: