

STATE ENGINEER
Salem, Oregon


Well Record **LANE** STATE WELL NO. 17/4W - 1M
COUNTY **LANE**
APPLICATION NO. GR-2057

OWNER: Allen A. Heisen & Margaret J. Heisen MAILING ADDRESS: 740 River Loop No. 2

LOCATION OF WELL: Owner's No. _____ CITY AND STATE: Eugene, Oregon

NW 1/4 SW 1/4 Sec. 1 T. 17 S., R. 4 W., W.M.

Bearing and distance from section or subdivision corner 484.5' S. and 2061.6' E.

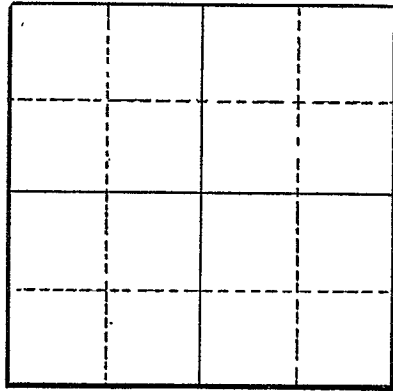

Section _____

Altitude at well _____

TYPE OF WELL: Driven Date Constructed 1947

Depth drilled 20 Depth cased 20

CASING RECORD:

4-inch

FINISH:

Perforations from 16 to 20

AQUIFERS:

Gravel

WATER LEVEL:

8-feet

PUMPING EQUIPMENT: Type Centrifugal H.P. 7 1/2
Capacity 250 G.P.M.

WELL TESTS:

Drawdown 2 ft. after _____ hours Pumping 180 G.P.M.
Drawdown _____ ft. after _____ hours _____ G.P.M.

USE OF WATER Irrigation Temp. _____ °F., 19
SOURCE OF INFORMATION GR-1982

DRILLER or DIGGER _____

ADDITIONAL DATA:

Log Water Level Measurements _____ Chemical Analysis _____ Aquifer Test _____

REMARKS:

Top loam 8 feet deep 0 8
Gravel 12 feet thick 8 20